



Direction, 1970

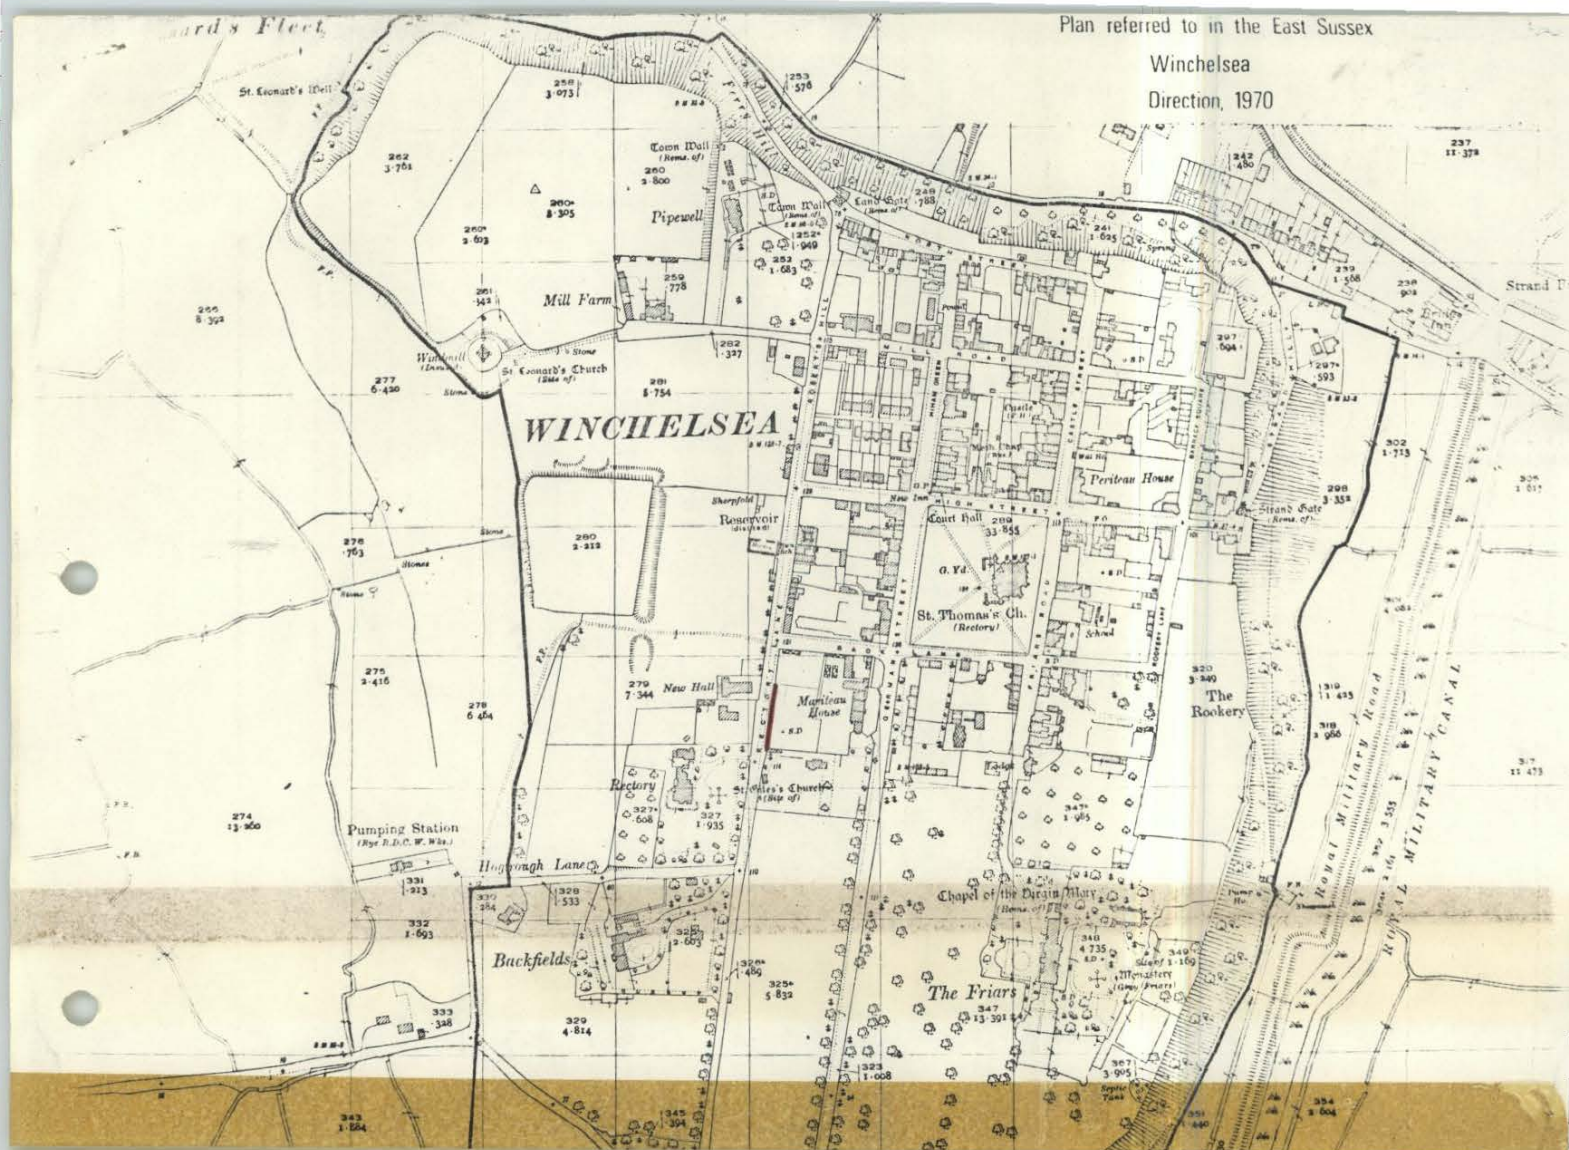

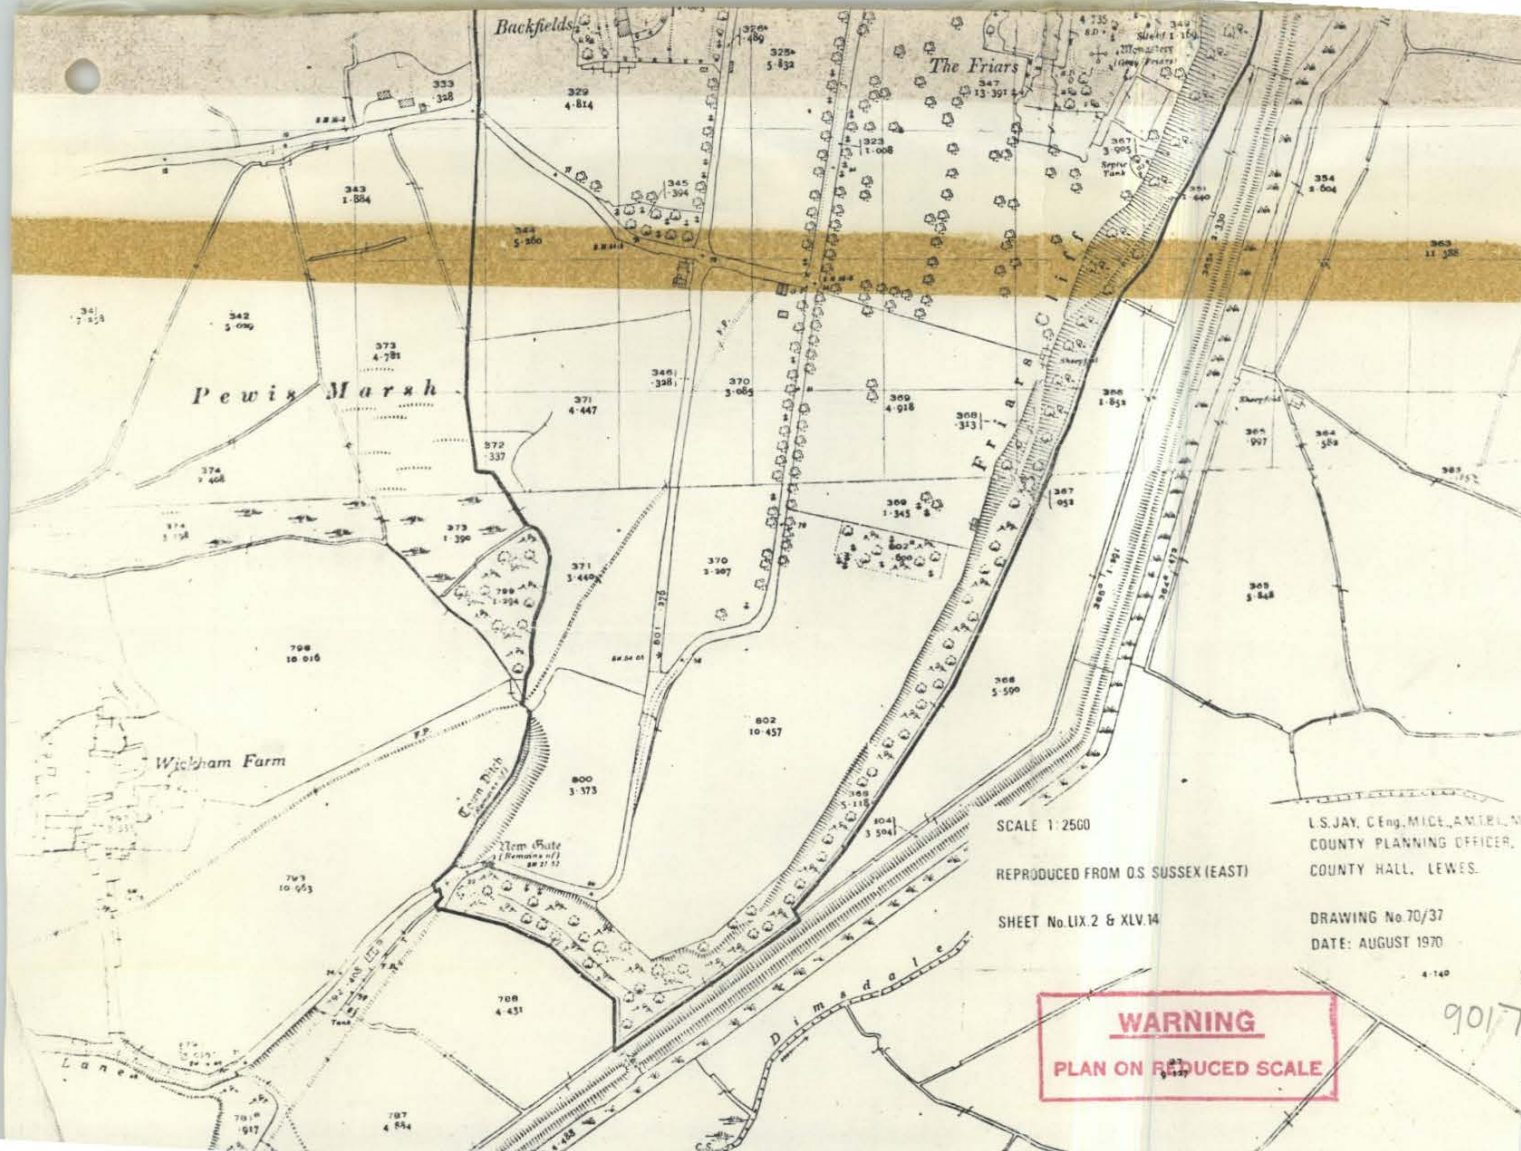

SCALE 1:2500

REPRODUCED FROM O.S. SUSSEX (EAST)

SHEET No. LIX.2 & XLV.14

L.S. JAY, C. Eng., MICE, AMICE, N.  
COUNTY PLANNING OFFICER,  
COUNTY HALL, LEWES.

DRAWING No. 70/37  
DATE: AUGUST 1970

**WARNING**  
PLAN ON REDUCED SCALE



COUNTY OF EAST SUSSEX

BATTLE RURAL DISTRICT

TOWN AND COUNTRY PLANNING GENERAL DEVELOPMENT ORDER 1963

13/0103/9

38/0278/92

TQ 901

WHEREAS the East Sussex County Council, as local planning authority, are satisfied that it is expedient that development of Class II.1. specified in Schedule 1 of the Town and Country Planning General Development Order 1963 should not be carried out within the area of land forming the Winchelsea Conservation Area and shown edged by a continuous black line on the plan attached hereto unless permission therefor is granted on an application duly made in that behalf.

NOW THEREFORE the County Council in exercise of the powers conferred upon them by Article 4 of the Town and Country Planning General Development Order 1963 HEREBY DIRECT that the permission granted by Article 3 of the said Order shall not apply in the area shown <sup>coloured red</sup> on the said plan to the said development.

This Direction may be cited as the East Sussex (Winchelsea) Direction 1970.

THE COMMON SEAL OF THE  
COUNTY COUNCIL OF EAST  
SUSSEX was affixed  
hereto in the presence  
of:-

G. R. Edwards

Deputy Clerk of the County Council

H.L.G. 49385  
The Minister of Housing and Local Government hereby approves the foregoing direction subject to the modifications shown in red ink therein.

Given under the official seal of the  
Minister of Housing and Local Government  
on 8 October 1970.

Paul M. Butler  
Assistant Secretary,  
Ministry of Housing and Local Government.